

R = 4805.30'  
 L = 187.01'  
 C = 187.00'  
 B = N 55°38'54" E  
 D = 02°13'48"

REPLACE WALK  
 PROPOSED VERTICAL CURB TO TAPER TO 0" @ EXISTING WALK IN 5' ALONG DRIVE TURN-OUT RADII (BOTH SIDES) (BOTH DRIVES-TYPICAL)  
 ENTIRE APRON TO BE 9" THICK

ENTIRE APRON TO BE 9" THICK


LAKELAND BOULEVARD 80'

NOTE:  
 ALL GRADE SHOTS TO GUTTER UNLESS OTHERWISE NOTED

NOTE:  
 ALL DIMENSIONS ARE FROM B/C TO B/C UNLESS OTHERWISE NOTED



"AS BUILT CERTIFICATION"  
 I HEREBY CERTIFY THAT THE CIRCLED ELEVATIONS ARE EXISTING FINISH GRADES CHECKED IN THE FIELD ON 08-01-2002 AND AS OF THAT DATE THE LOT CORNER IRON PINS WERE EXISTING AND THAT SURVEY IS CORRECT TO THE BEST OF KNOWLEDGE AND BELIEF.  
 BY: John L. Skowieczny  
 REG. NO. 14336

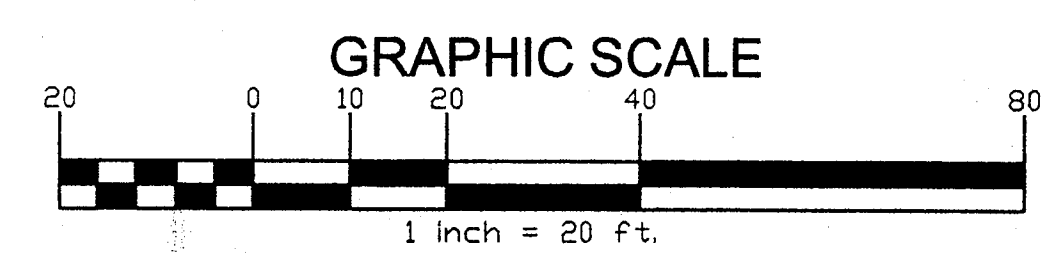

"AS BUILT" FOR: LAKETRAIN PARKING EXPANSION			
SCALE: 1" = 20'	APPROVED:	DRAWN BY: SWC	REVISED:
DATE: OCT. 02			
JOB# 02-3383		DRAWING NUMBER 02-2164	